





DIST	COUNTY	ROUTE	KILOMETER TOTAL PROJECT	POST TOTAL PROJECT	SHEET NO	TOTAL SHEETS
04	SF, Alameda	80	12.2/14.3	0.0/4.0	407a	1204
SYN YEE CHIN			03/08/10		REGISTERED ELECTRICAL ENGINEER DATE	
05-06-2010			PLANS APPROVAL DATE		REGISTERED PROFESSIONAL ENGINEER	
PB AMERICAS, Inc.			A Parsons Brinckerhoff Company		303 Second St., Suite 700N San Francisco, CA 94107-1317	
The State of California or its officers or agents shall not be responsible for the accuracy or completeness of electronic copies of this plan sheet.						
Caltrans now has a web site. To get to the web site, go to <a href="http://www.dot.ca.gov">http://www.dot.ca.gov</a>						

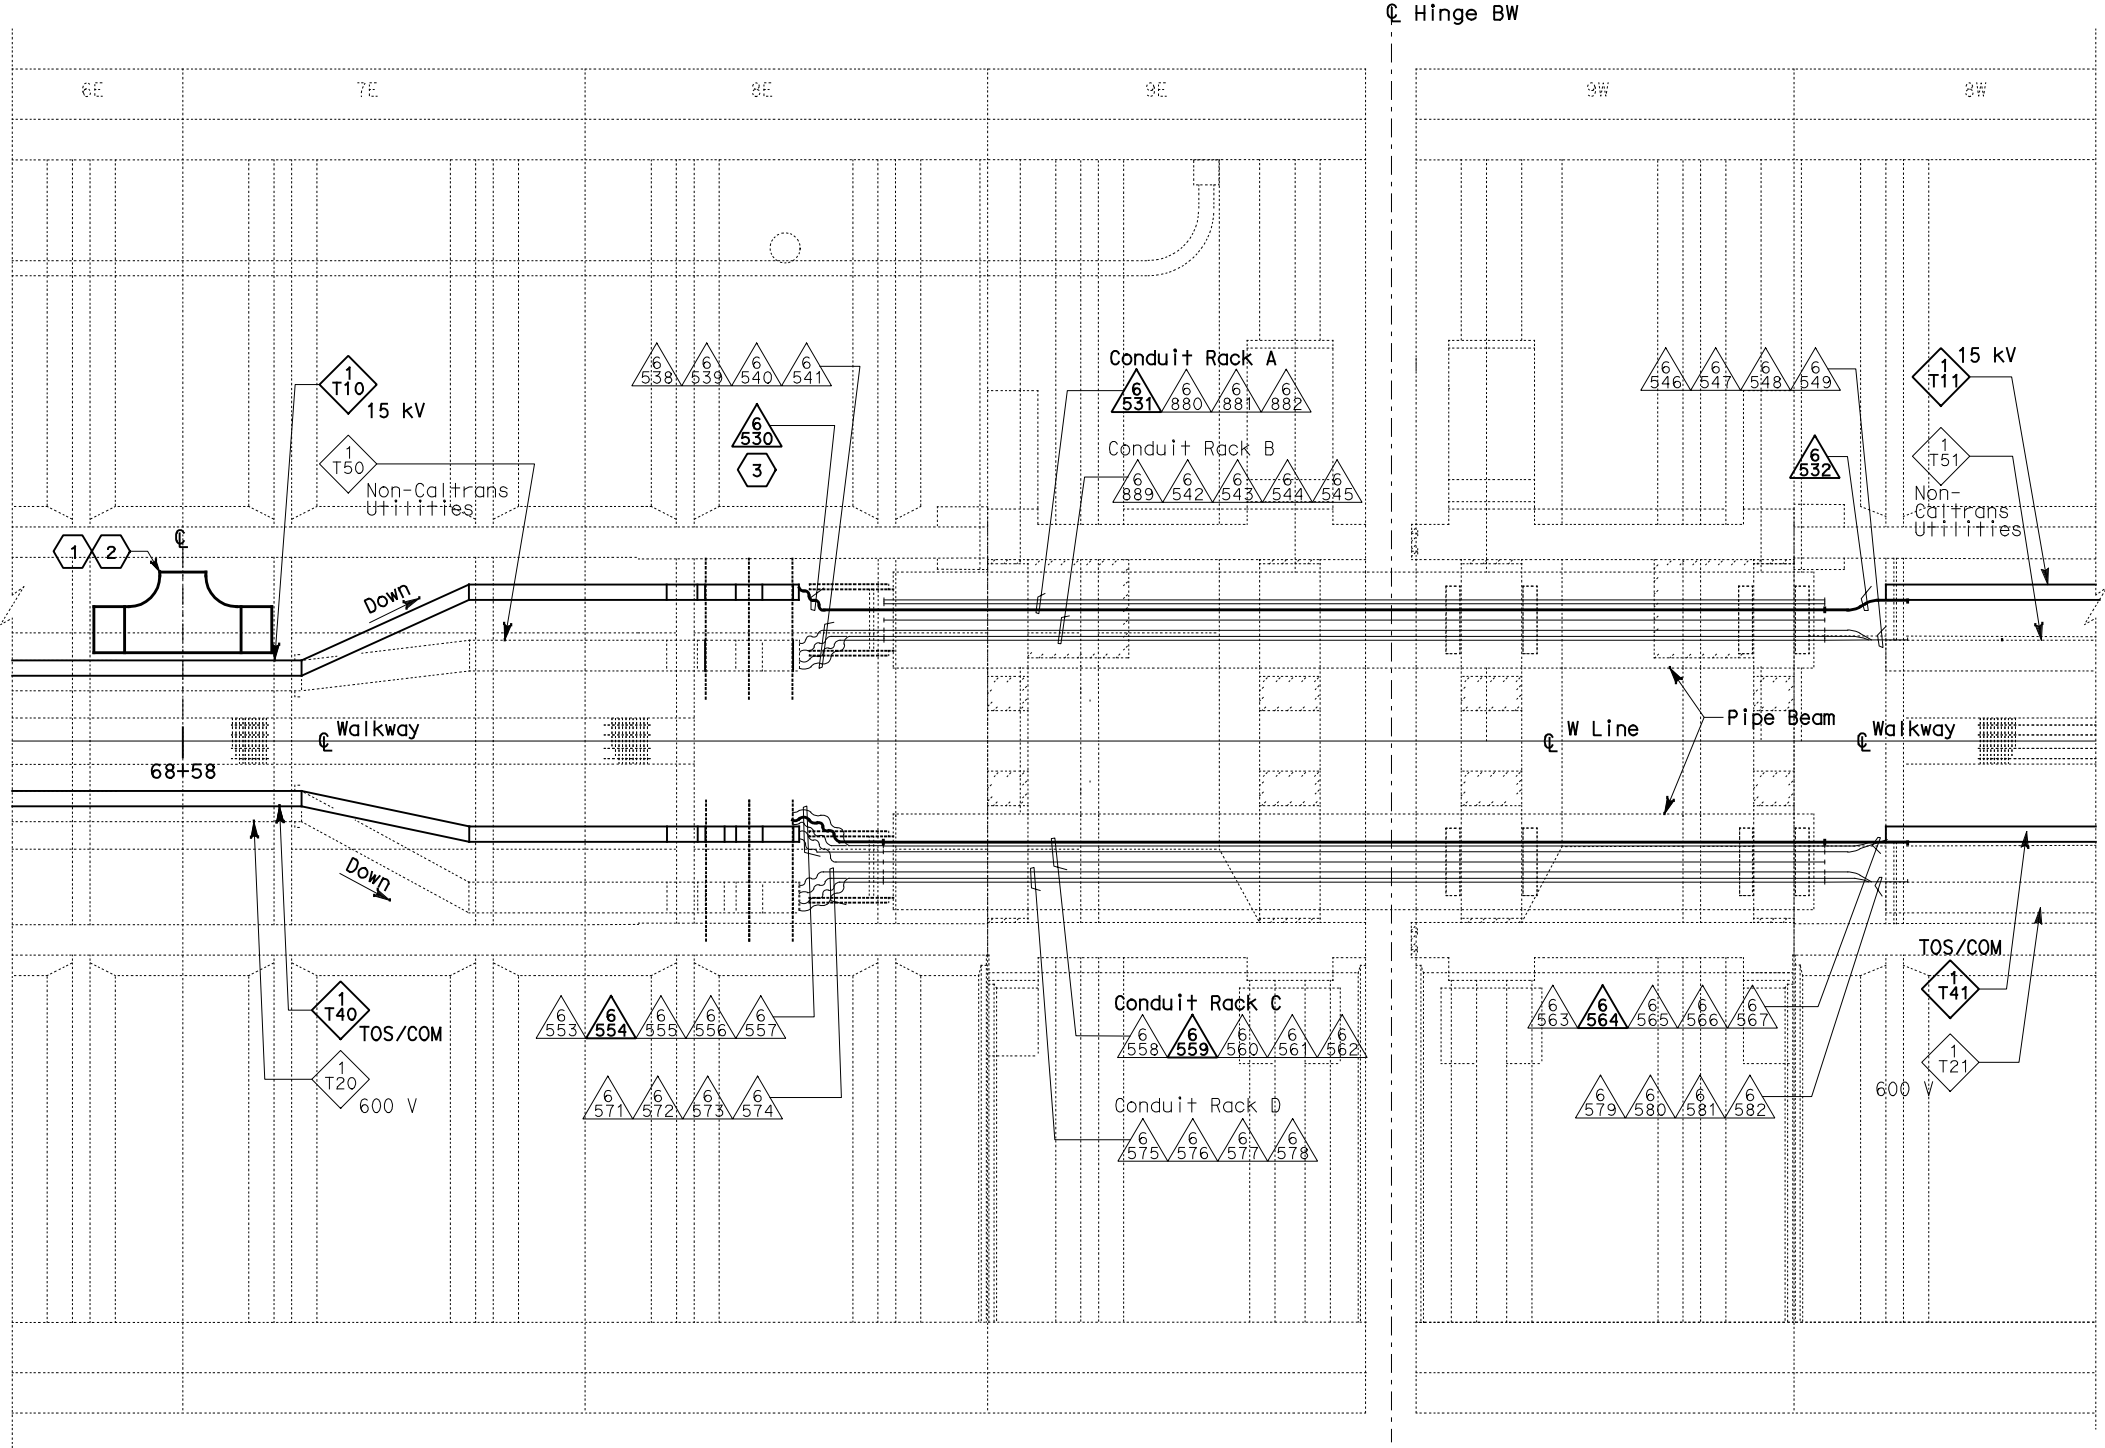

- NOTES:
- This plan sheet is a record drawing from Skyway Structures contract. The Contractor shall verify the existing installation. See sheet EE-296A from Skyway Structures, contract No. 04-012024.
  - The installed components shall not be limited to the ones listed below, but shall be a complete installation. For details, see Bridge Structures Girder Westbound, typical Details sheets.
    - Furnish and install the 15kV cables into existing cable trays and conduits shown on this drawing. See sheets E-664 and E-665.
    - Furnish and install fiber optic cables into existing cable trays and conduits shown on this drawing. See sheets E-978 through E-981.
    - Inspect for system ground continuity. See sheets E-666 and E-667.
  - All cable trays and conduits shown on this drawing are existing. Bold ones are to be used for pulling cable.

- SHEET NOTES:
- Furnish and install splice cable tray as shown on sheet E-663, plan detail 1.
  - Mount splice cable tray between diaphragms at Station 68+58 as shown on sheet E-605 and secure properly. See sheet E-663, section detail 4.
  - In order to be able to pull the 15kV cable, the Contractor shall disassemble the 15kV flexible conduit installation. The 15kV flexible conduit shall be reinstalled after the 15kV cable has been installed.

PLAN - HINGE BW  
SCALE: 1:75

REQUEST FOR INFORMATION NOT ADDRESSED IN THIS CCO REMAIN IN FORCE							
	03/08/10	MEP INTEGRATION			SYC	FW	110
MARK	DATE	DESCRIPTIONS			BY	CH'D	CCO#
REVISIONS							


CONTRACT CHANGE ORDER NO. \_\_\_\_\_  
SHEET \_\_\_\_\_ OF \_\_\_\_\_

DETAILS  
BRIDGE STRUCTURES GIRDER WESTBOUND  
SKYWAY STRUCTURES-HINGE BW  
SCALE AS NOTED

THIS PLAN ACCURATE FOR ELECTRICAL WORK ONLY.

ALL DIMENSIONS ARE IN METERS UNLESS OTHERWISE SHOWN

FOR REDUCED PLANS ORIGINAL  
SCALE IS IN MILLIMETERS

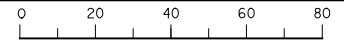

DGN FILE => 04-0120f1\_E-642.dgn  
USERNAME => ilorico

CU 04251

EA 0120F1